DO NOT SCALE PRINT

DWG. NO. 1-1437507-0 REV.

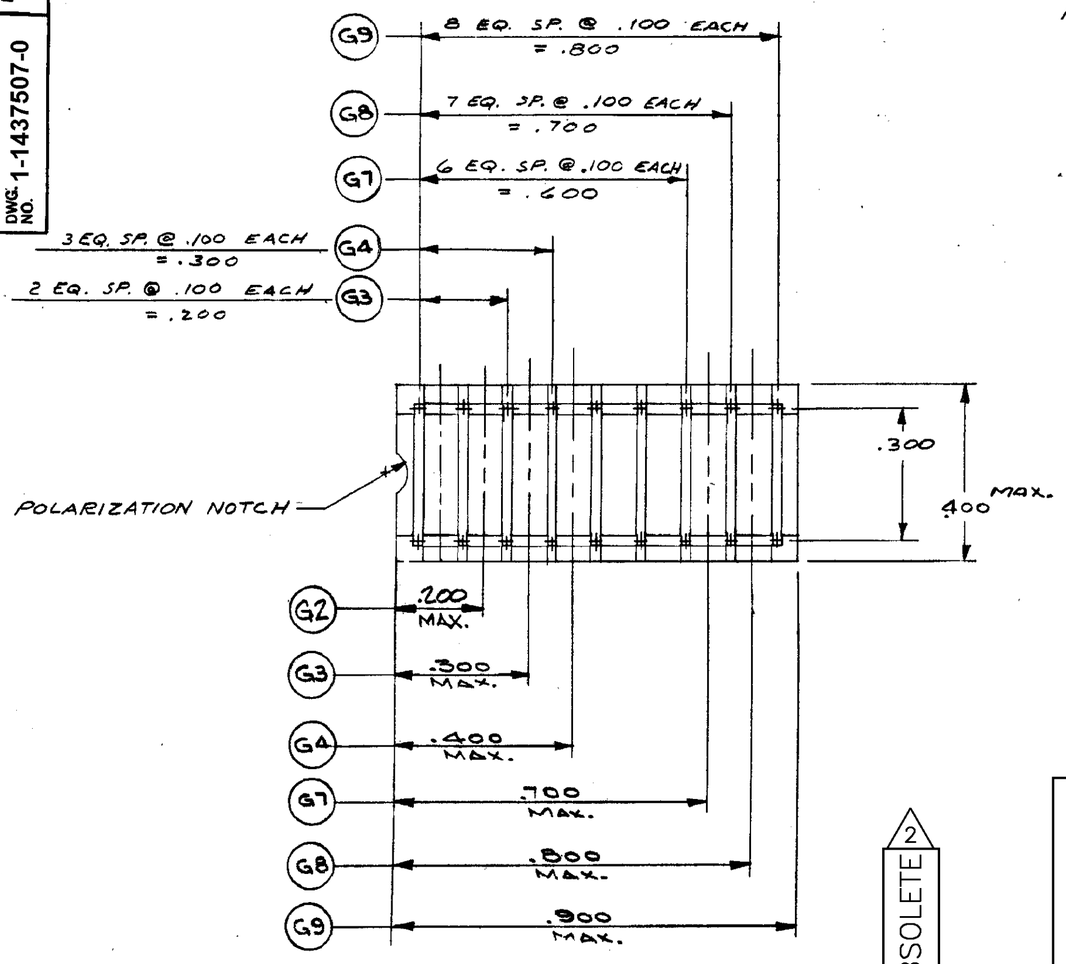

NOTES:

1. MATERIAL AND FINISH:
   INSULATOR ____ THERMOPLASTIC POLYESTER UL RATED 90 V-0; COLOR-BLACK
   (G) CONTACT ____ PHOSPHOR BRONZE, GOLD OVER NICKEL PLATE
   (GT) CONTACT ____ PHOSPHOR BRONZE, TIN PLATE.

2 OBSOLETE PARTS: OBSOLETE CIS STREAMLINING PER D.RENAUD/D.SINISI

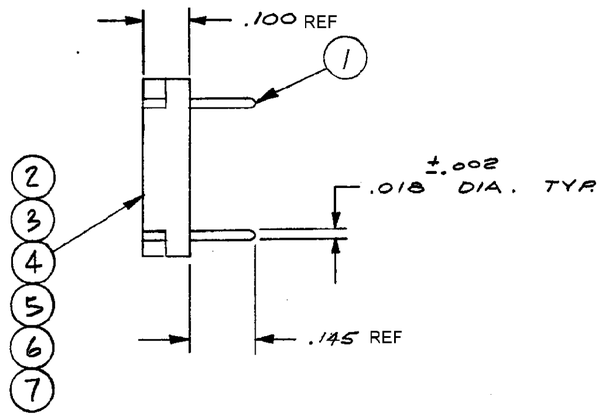

PART NO.S																	
	N/A	~~1-1437507-2~~ OBSOLETE 2	1-1437507-1	N/A	~~3-1437506-2~~ SUP BY 2-1437507-1	2-1437507-0	~~1-1437507-8~~ OBSOLETE 2	1-1437507-6	~~1-1437507-4~~ OBSOLETE	1-1437507-0	2-1437507-1	1-1437507-9	1-1437507-7	1-1437507-5	1-1437507-3		
SHORTING PIN	9	8	7														1
SHORTING PIN				2	9	8	7	4	3								1
INSULATOR				1						1							7
INSULATOR	1				1						1						6
INSULATOR		1				1						1					5
INSULATOR			1				1						1				4
INSULATOR								1						1			3
INSULATOR									1						1		2
SHORTING PIN										2	9	8	7	4	3		1
DESCRIPTION	G25	G24	G23	G2T	G9T	G8T	G7T	G4T	G3T	G2	G9	G8	G7	G4	G3		ITEM NO.
	QUANTITY									QUANTITY							

UNLESS OTHERWISE SPECIFIED DIMENSIONS ARE IN INCHES
TOLERANCES ON
FRACTIONS DECIMALS ANGLES
REF

MATERIAL: —

FINISH: —

ORIGINAL DATE OF DRAWING: 4-4-73	
DRAWN: RJS	DATE: 4-4-74
CHECKED: R.J.H.	DATE: 4-5-74
APPROVED: R.J.H.	DATE: 4-5-74
CODE IDENT. NO. 91506	DWG. SIZE C
NEXT ASSY.	

TE Connectivity

TITLE: PROGRAMMING PLUG

DWG. NO. 1-1437507-0 REV. A1

SCALE: 4X1 SHEET 1 OF 1

LTR	REVISION RECORD	DR	CHK	DATE
A1	REVISED PER ECO-11-005140	RK	HMR	31MAR11

CUSTOMER DWG.